


Schedule of Accommodation					
Type	No	Area		Total area	
		sq.m	sq.ft.	sq.m	sq.ft.
Apartment					
Type 1	3	83.00	878.13	189.00	2034.40
Type 2	3	66.70	717.98	200.10	2153.88
Type 3	2	67.00	721.19	134.00	1442.36
Type 3a	1	58.00	624.31	58.00	624.31
Type 4	4	81.00	856.60	244.00	2626.42
Type 5	5	59.00	635.08	295.00	3175.38
Type 6	5	58.00	624.31	290.00	3121.56
Type 7	5	60.37	649.82	301.85	3249.11
Type 8	10	59.50	640.46	595.00	6404.58
Type A	5	145.90	1570.47	729.50	7852.34
Type B	8	137.00	1474.87	1098.00	11797.34
Type C	8	193.30	2080.88	1159.80	12484.09
Type D	15	83.58	899.44	1253.40	13491.80
Type E	2	89.40	747.02	138.80	1494.04
Type F	2	38.10	410.11	78.20	820.22
Type G	2	44.20	475.77	86.40	951.54
Type Ga	2	42.60	458.55	85.20	917.09
	80			6934.25	74840.27

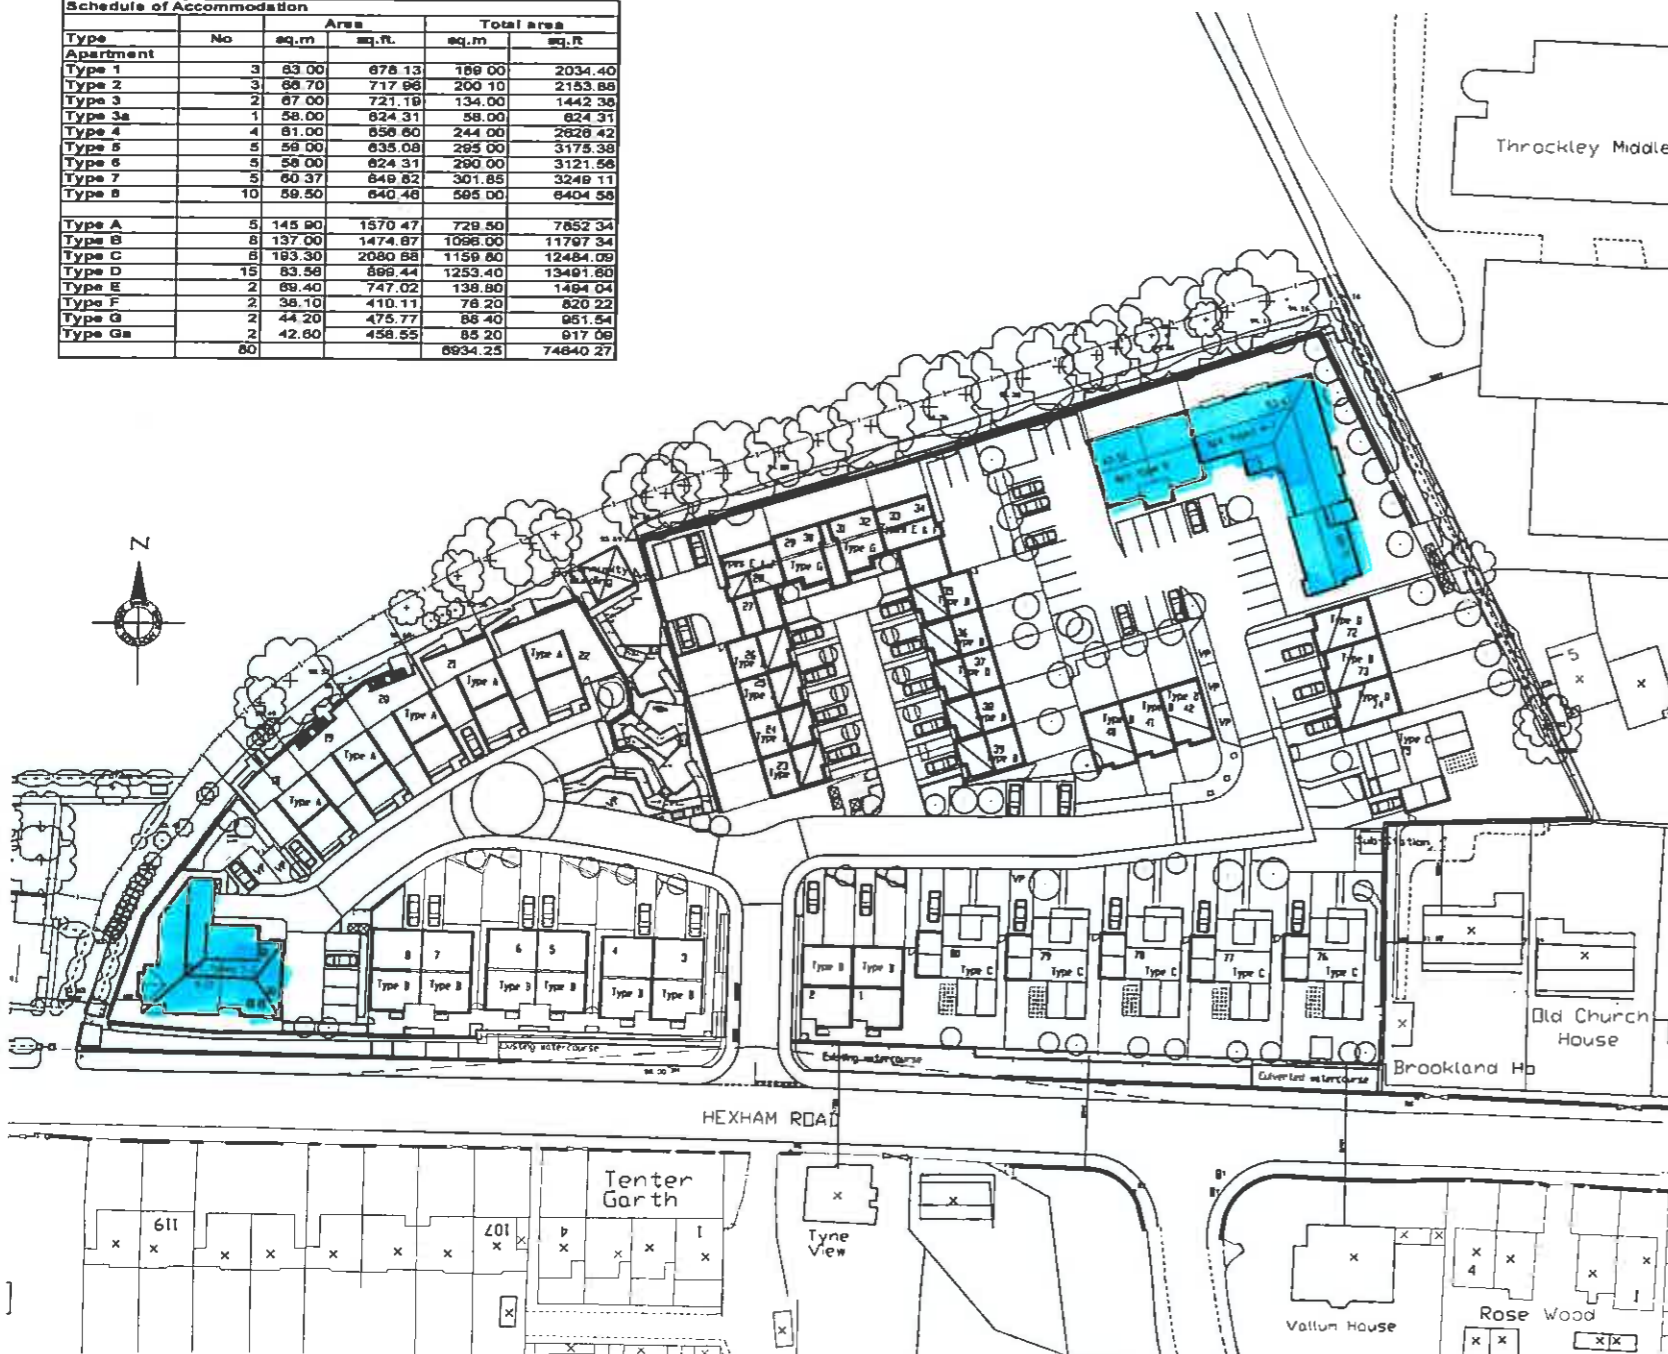

NOTES
Do not scale from this drawing. Only figured dimensions are to be taken from this drawing.

Contractor must verify all dimensions on site before commencing any work or shop drawings.

Report any discrepancies before commencing work to the Architect. If this drawing exceeds the quantities taken in any way the Architects are to be informed before the work is initiated.

Work within the Construction (Design & Management) Regulations 1994 is not to start until a Health and Safety Plan has been produced.

This Drawing is Copyright and must not be reproduced without consent of Browne Smith Baker Architects.

Drawing Status/Type Key:
 F - Feasibility stage drawing
 P - Planning stage drawing
 T - Tender stage drawing
 C - Construction stage
 AB - As Built Drawings
 TNY - Tenant drawing
 SK - Sketch drawing
 M - Marketing drawing
 L - Landscape Drawing
 S - Survey drawing
 OS - Ordnance Survey drawing

Rev: Description Date
 A: Roads, PDS & courtyards revised 18/01/08
 B: Plots 3, 44-51 revised to client comments 18/01/08
 C: Triplex units revised to client comments 18/01/08
 D: Apartment type 7 amended 17/02/08
 E: Position of tank walls corrected 26/02/08
 F: Service strips and VP's added 02/04/08
 G: Landscaping added 18/04/08
 H: Dimensions added 24/04/08
 J: Layout Revised 01/05/08
 K: Layout revised Schedule revised 14/05/08
 N: Layout revised and schedule revised 21/05/08

Browne Smith Baker
Architects
11-12 Portland Terrace,
Newcastle upon Tyne, NE2 1QQ
Tel: 0191 212 1133
Fax: 0191 212 0777
e-mail: info@brownesmithbaker.com

PROJECT
Throckley Waterworks
for Esh Group

DRAWING TITLE
Site Layout

Scale @ A2
1:500

Drawn by
RE

Date Drawn
Dec 07

Checked By
Date Checked

Drawing No.
07016/F/002

Revision
M

REVISED
27.05.08

